




No. #2

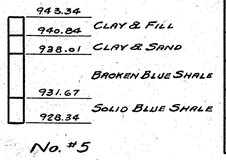


No. #5

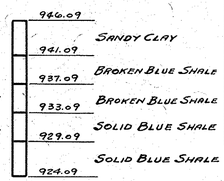

No. #9A

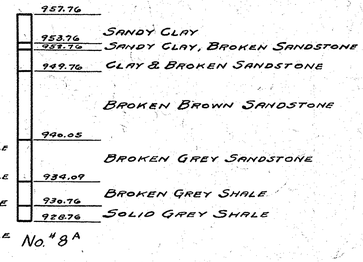


No. #8A

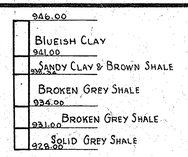


No. #15




No. #11

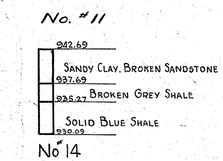


No. #14

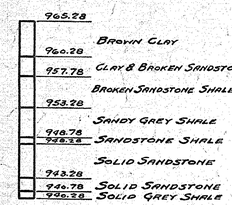


No. #1

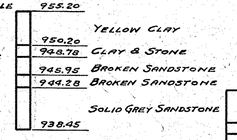


No. #3

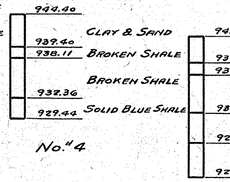


No. #4

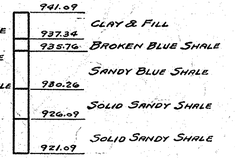


No. #6

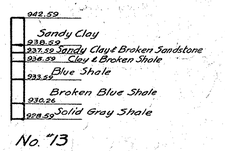


No. #13

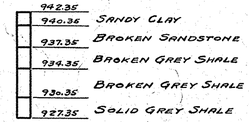


No. #7

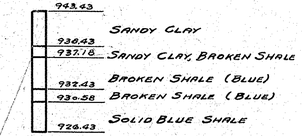


No. #10

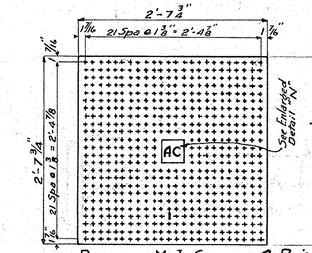


DETAIL OF M.I. COVER 3-REQ'D.

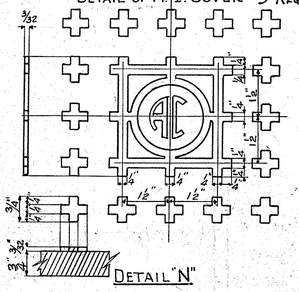


DETAIL "N"

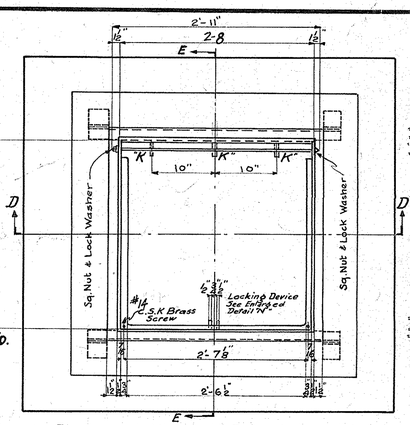

DETAIL OF MANHOLE FRAME (Malleable Iron) 3-REQ'D.

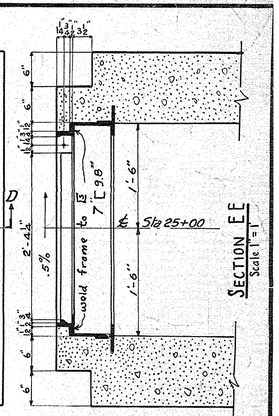


SECTION E-E
Scale 1"=1'

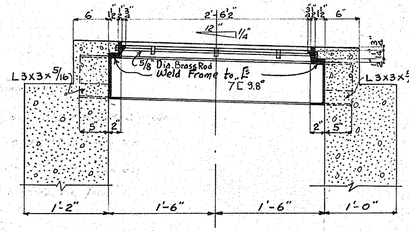


SECTION DD
Scale 1"=1'

Manhole Frame and Cover to be paid for under Item 23B. Dwg.#15519
Steel Supports to be paid for under Item 6B. Dwg. #15519.

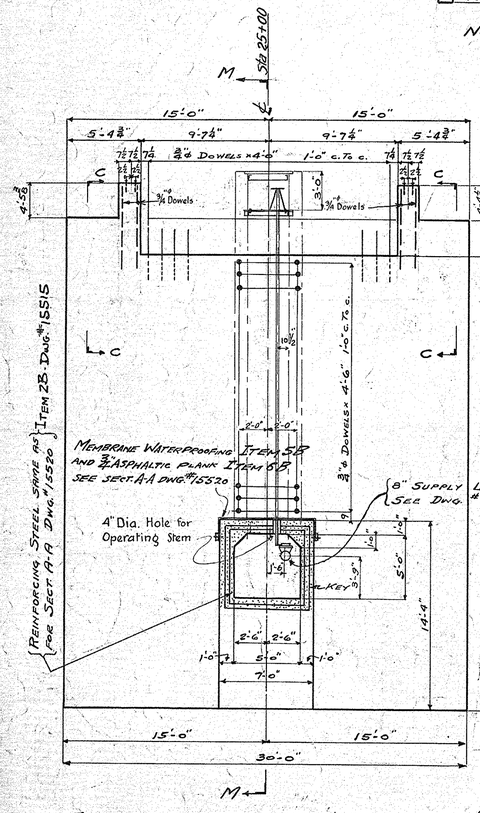

ENLARGED DETAIL OF CORE WALL AT STA. 25+00 (For Location See Dwg.#15515)
Scale 3/8"=1'-0"

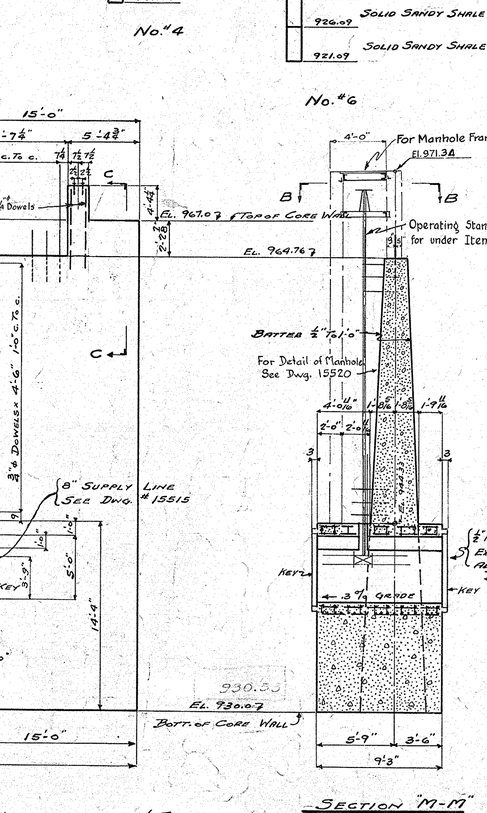


SECTION "M-M"
Scale 3/8"=1'-0"


TEST HOLES
Scale 1"=10'
For Location See Dwg. #15515

SECTION "B-B"
Scale 1/2"=1'-0"

For Detail of Expansion Joint See Dwg.#15520

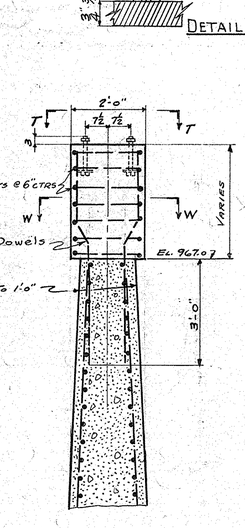


SECTION "C-C"
Scale 1/2"=1'-0"

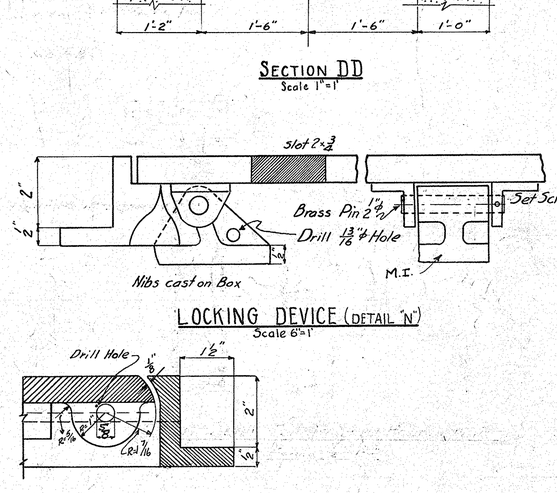


LOCKING DEVICE (DETAIL "N")
Scale 6"=1'


ENLARGED DETAIL OF HINGE "K"
Scale 6"=1'

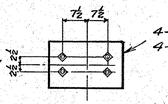


SECT "T-T"

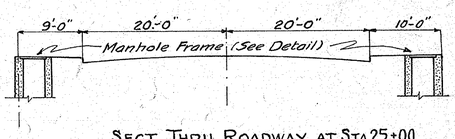

SECT THRU ROADWAY AT STA 25+00
Showing Location of Manholes
Scale 1"=10'

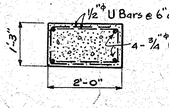

SECTION "WW"

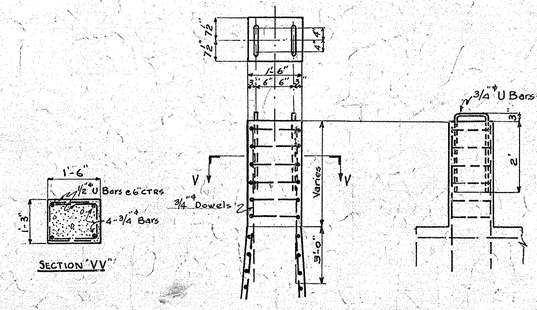

TYPICAL DETAIL FOR RAILING FOUNDATION
Scale 1/2"=1'-0"

SECTION "VV"

IN CHARGE	A.E. Olson	DRAWN	J.A.C.	7/30/35	CHECKED	W.F. Thomas	8-27-35

REVISIONS

NO.	ORDERED	MADE	DATE	CHECKED	REMARKS
(A)	S.A. Shubin	J.A.C.	9/18/35		Changes Caused By Addition of "A" Supply Line.
	S.A.S.	C.L.H.	3/15/37		Notations in Sec. Shown Structures as Built

Dimensions, Elevations and Details shown in (A) designate structures as built

SUBMITTED JUNE 6, 1935
BRIDGE DESIGN ENGINEER

APPROVED
PLANNING ENGINEER

COUNTY OF ALLEGHENY
PITTSBURGH, PA.

BABCOCK BOULEVARD
COREWALL
NORTH PARK DAM
NORTH PARK, McCANDLESS TOWNSHIP
SECTIONS & DETAILS
SCALES AS SHOWN JUNE 6, 1935
SHEET 2 OF 2 SHEETS