





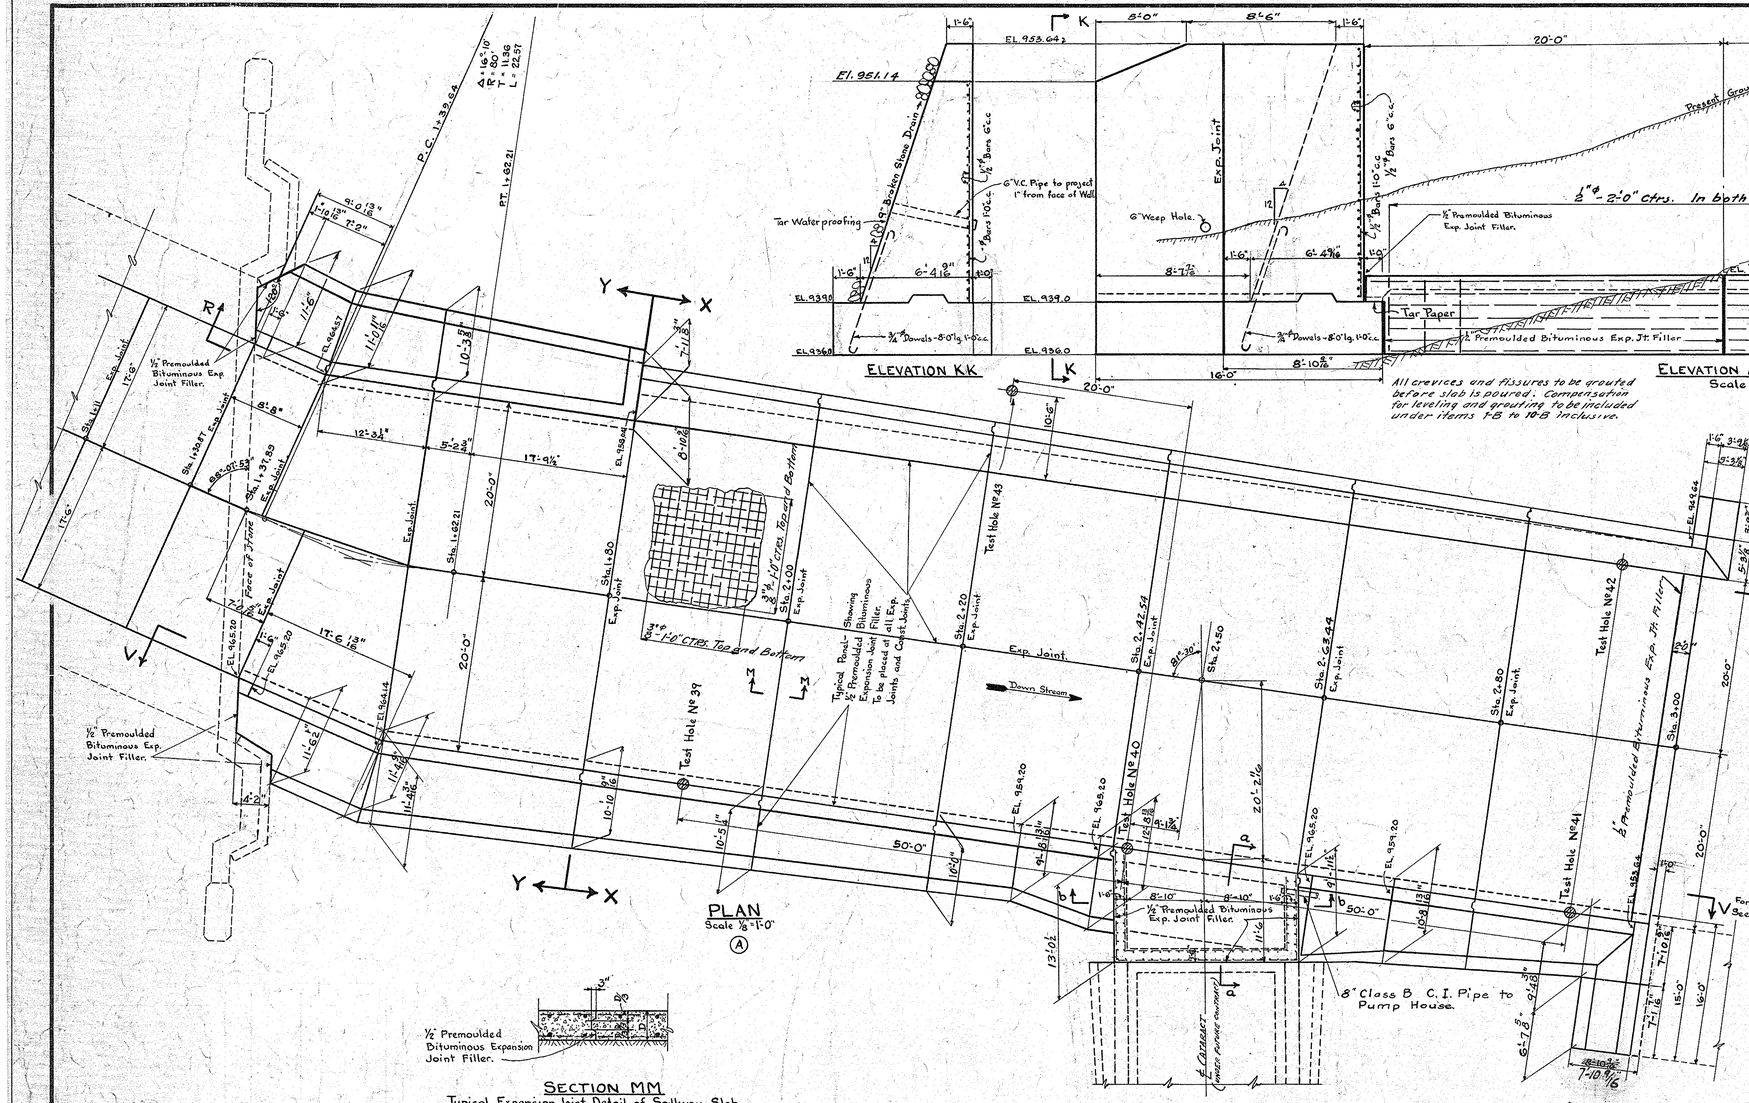


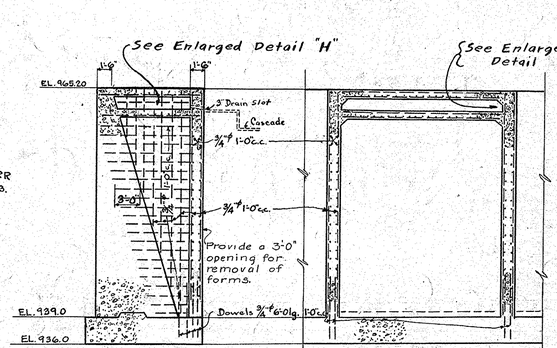


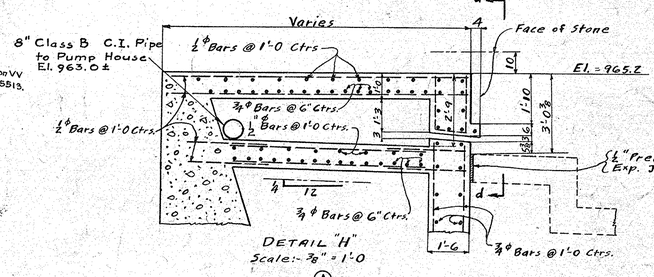

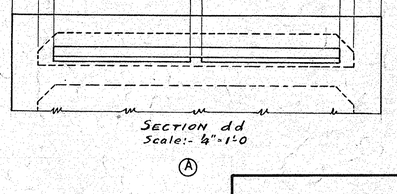



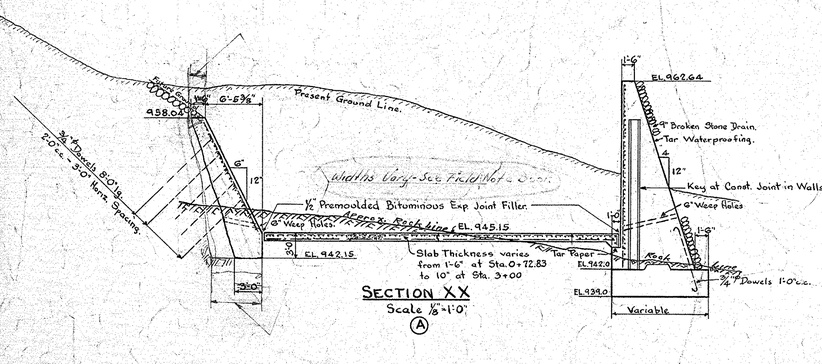Detail Dimensions and Elevations shown in red indicate structure as built.
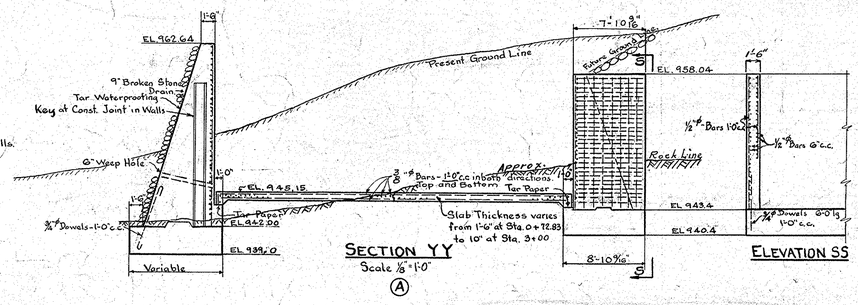
| IN CHARGE | A.E. Olson | DRAWN | F.R. Shuntich 7/1/35 | CHECKED | W.F. Thomas 10-4-35 |
|---|---|---|---|---|---|

REVISIONS

| O. | ORDERED | MADE | DATE | CHECKED | REMARKS |
|---|---|---|---|---|---|
| ) | S.A. SHUBIN | F.R.S. | 8/13/35 | | Changes made by lowering Spillway Floor |
| | S.A.S. | C.L.M. | 3-10-37 | | ELEVATIONS & C.O. SHOW STRUCTURES AS BUILT |
| | | | | | |
| | | | | | |
| | | | | | |

**SUBMITTED JUNE 6, 1935**

BRIDGE DESIGN ENGINEER

**APPROVED**

PLANNING ENGINEER

# COUNTY OF ALLEGHENY PITTSBURGH, PA.

## BABCOCK BOULEVARD SPILLWAY NORTH PARK DAM

NORTH PARK, Mc CANDLESS TOWNSHIP

## PAVING & SECTIONS OF SPILLWAY

SCALES AS SHOWN JUNE 6, 1935

SHEET 4 OF 4 SHEETS